

Floor 34

Suite 3400

~20,095 SQFT

High-Rise | Base Plan

Tom McDonnell

tmcdonnell@shorenstein.com

(415) 772-7086

Lic. #01011145

Jim Collins


jcollins@shorenstein.com

(415) 352-7239

Lic. #00860991



45 Fremont St. San Francisco, CA 94105

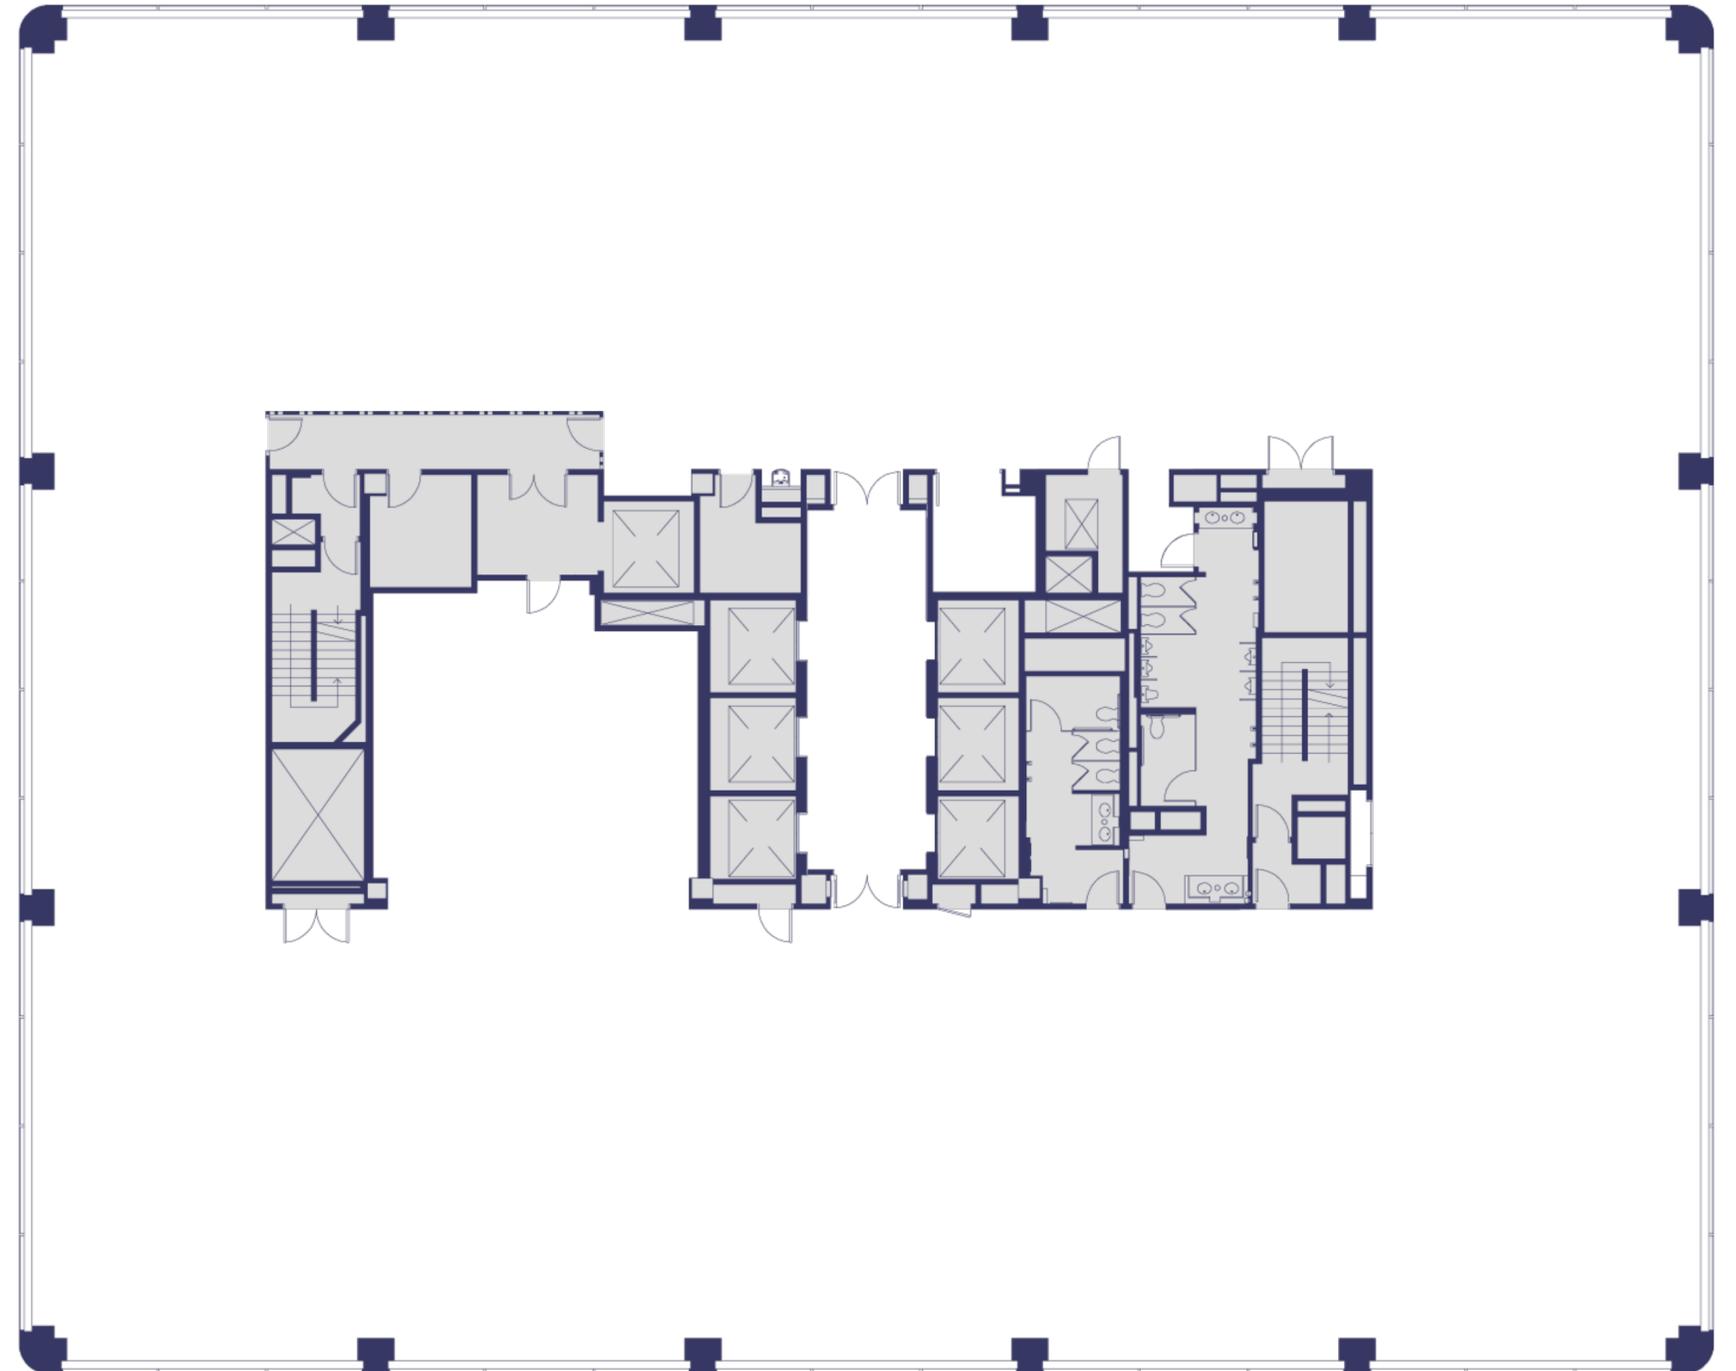

Floor 34

Suite 3400

~20,095 SQFT

High-Rise | As Built

Tom McDonnell

tmcdonnell@shorenstein.com

(415) 772-7086

Lic. #01011145

Jim Collins


jcollins@shorenstein.com

(415) 352-7239

Lic. #00860991



45 Fremont St. San Francisco, CA 94105

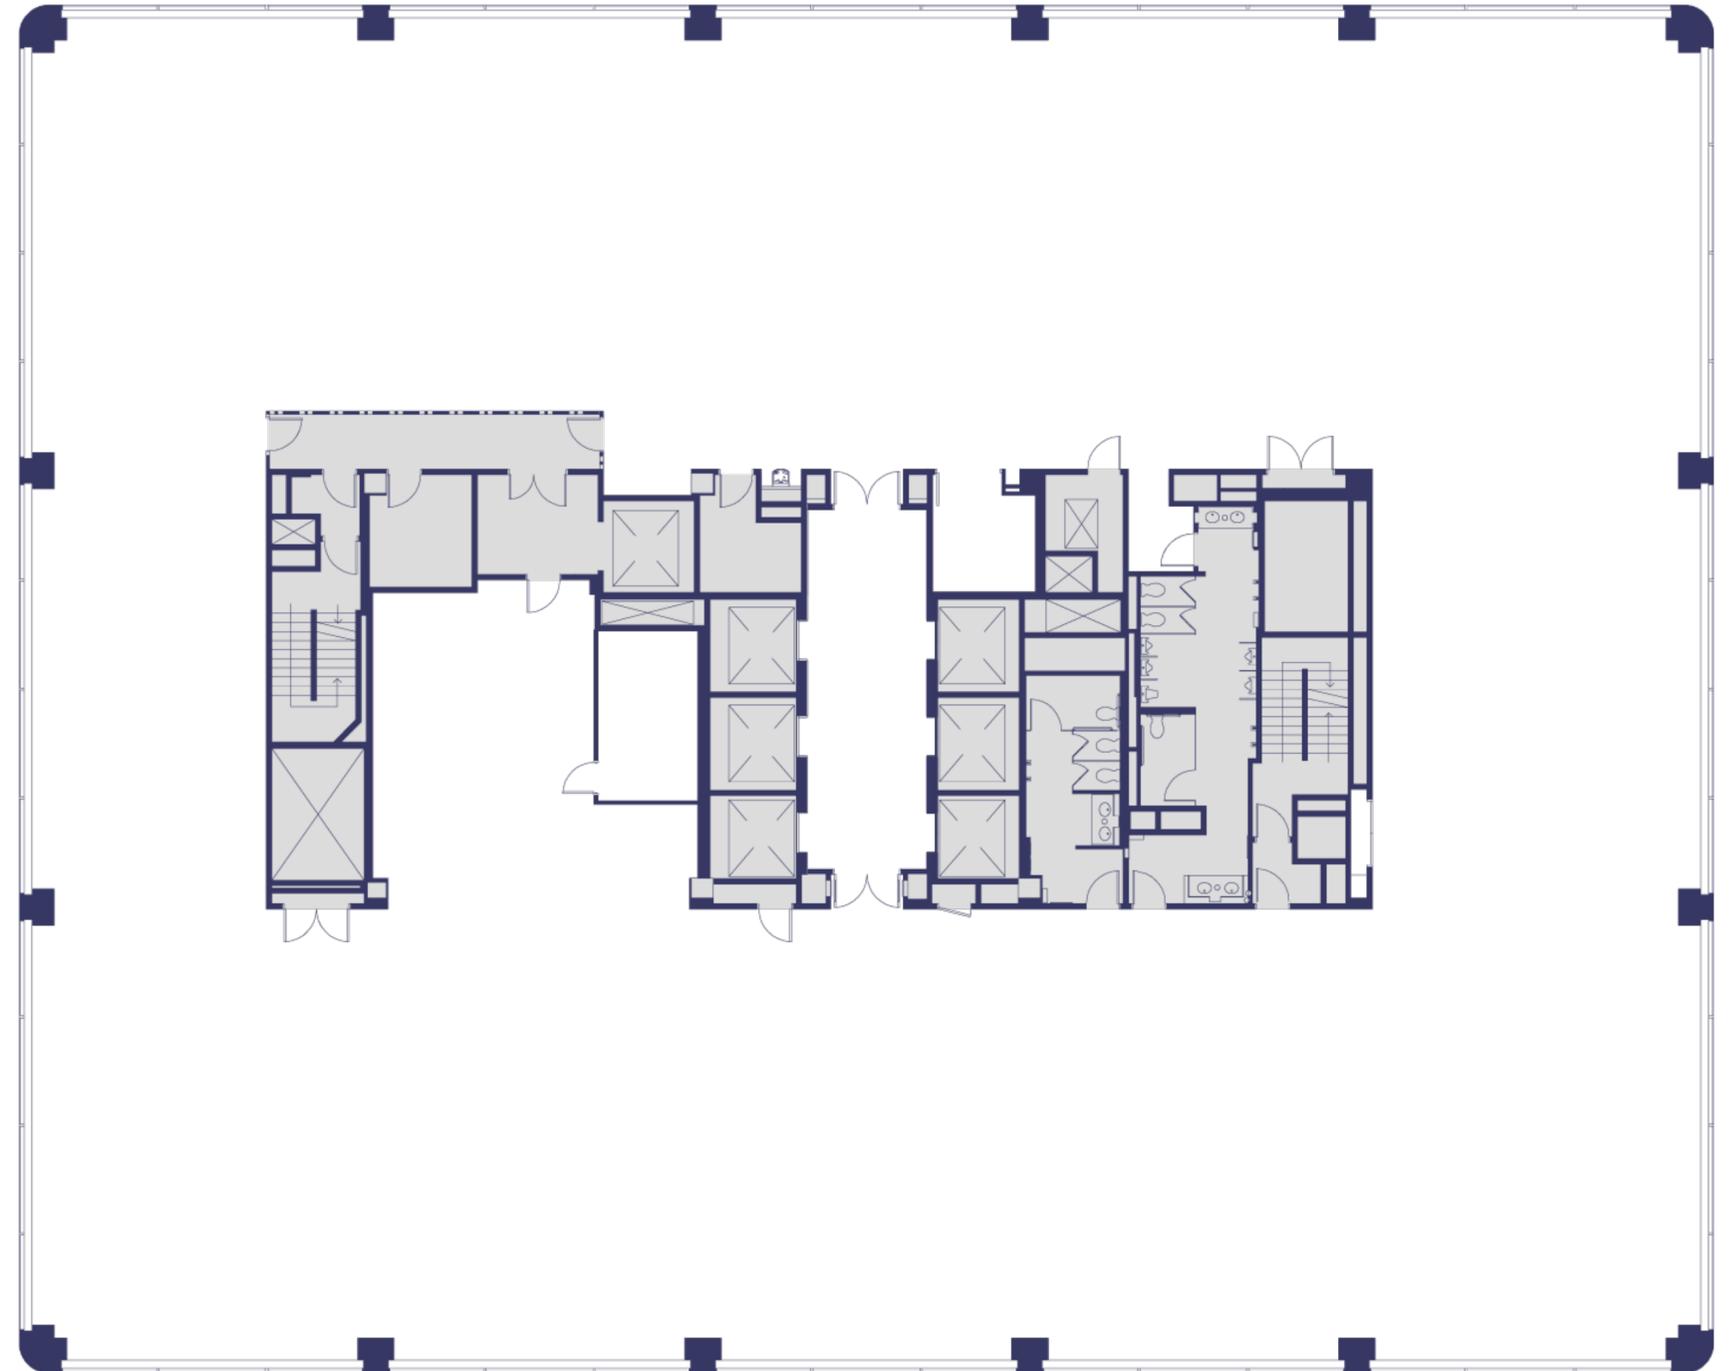

Floor 34

Suite 3400

~20,095 SQFT

High-Rise | Hypothetical Private Office

- 44 Private Offices
- 1 Large Conference Room
- 4 Medium Conference Room
- 6 Small Meeting Rooms
- 14 Workstations
- 1 Break Room
- 1 Reception Area
- 1 Server Room
- 1 Wellness Room
- 2 Copy / Supply Rooms
- 1 Interview Room

Tom McDonnell

tmcdonnell@shorenstein.com

(415) 772-7086


Lic. #01011145

Jim Collins

jcollins@shorenstein.com

(415) 352-7239

Lic. #00860991

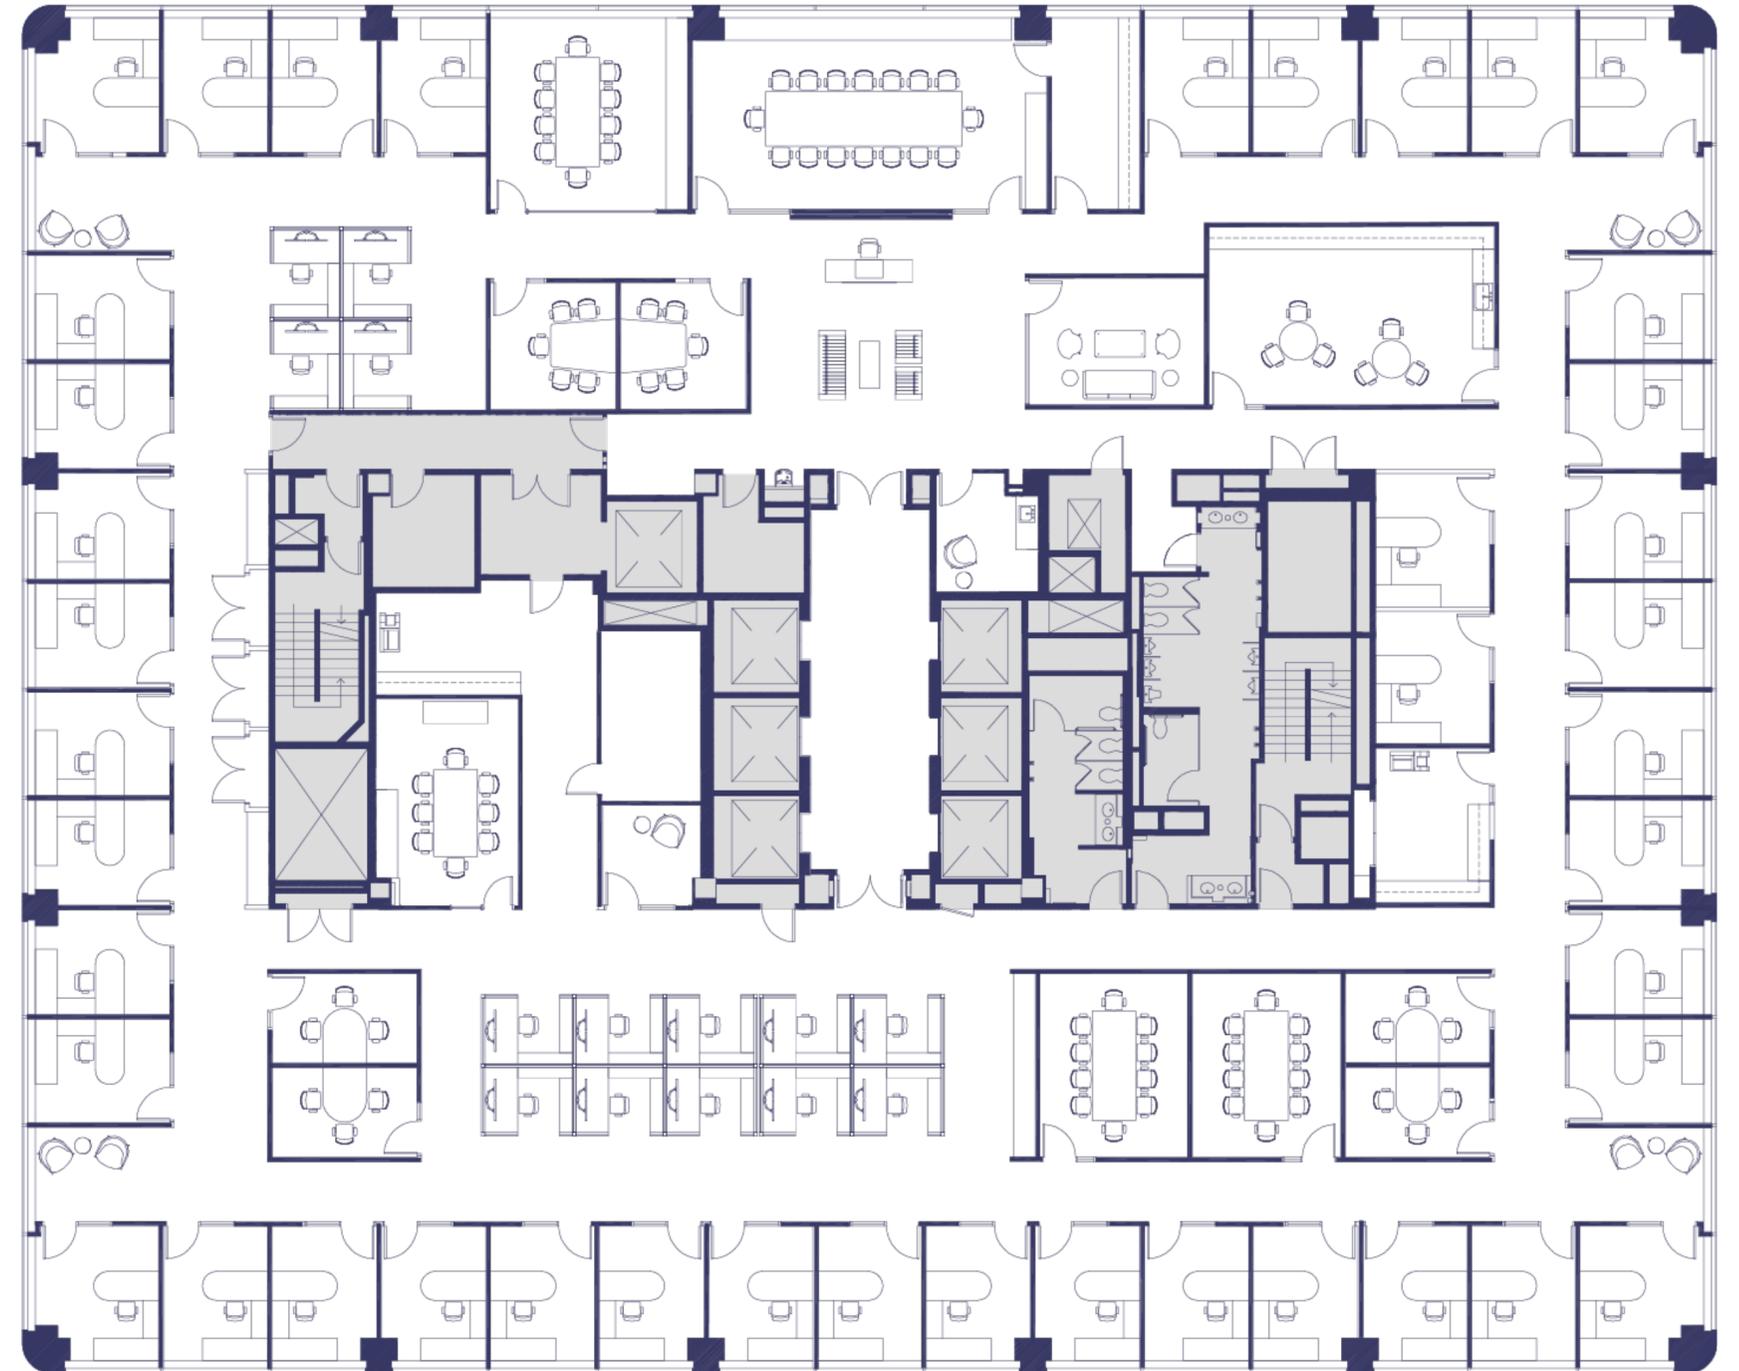

45 Fremont St. San Francisco, CA 94105



Floor 34

Suite 3400

~20,095 SQFT

High-Rise | Hypothetical Open Office

- 10 Private Offices
- 1 Large Conference Room
- 5 Medium Conference Room
- 5 Small Meeting / Huddle Rooms
- 66 Workstations
- 1 Break Room
- 1 Reception Area
- 1 Lounge
- 1 Server Room
- 1 Wellness Room
- 2 Copy / Supply Rooms
- 2 Interview Rooms

Tom McDonnell

tmcdonnell@shorenstein.com

(415) 772-7086

Lic. #01011145

Jim Collins

jcollins@shorenstein.com

(415) 352-7239

Lic. #00860991



45 Fremont St. San Francisco, CA 94105

